



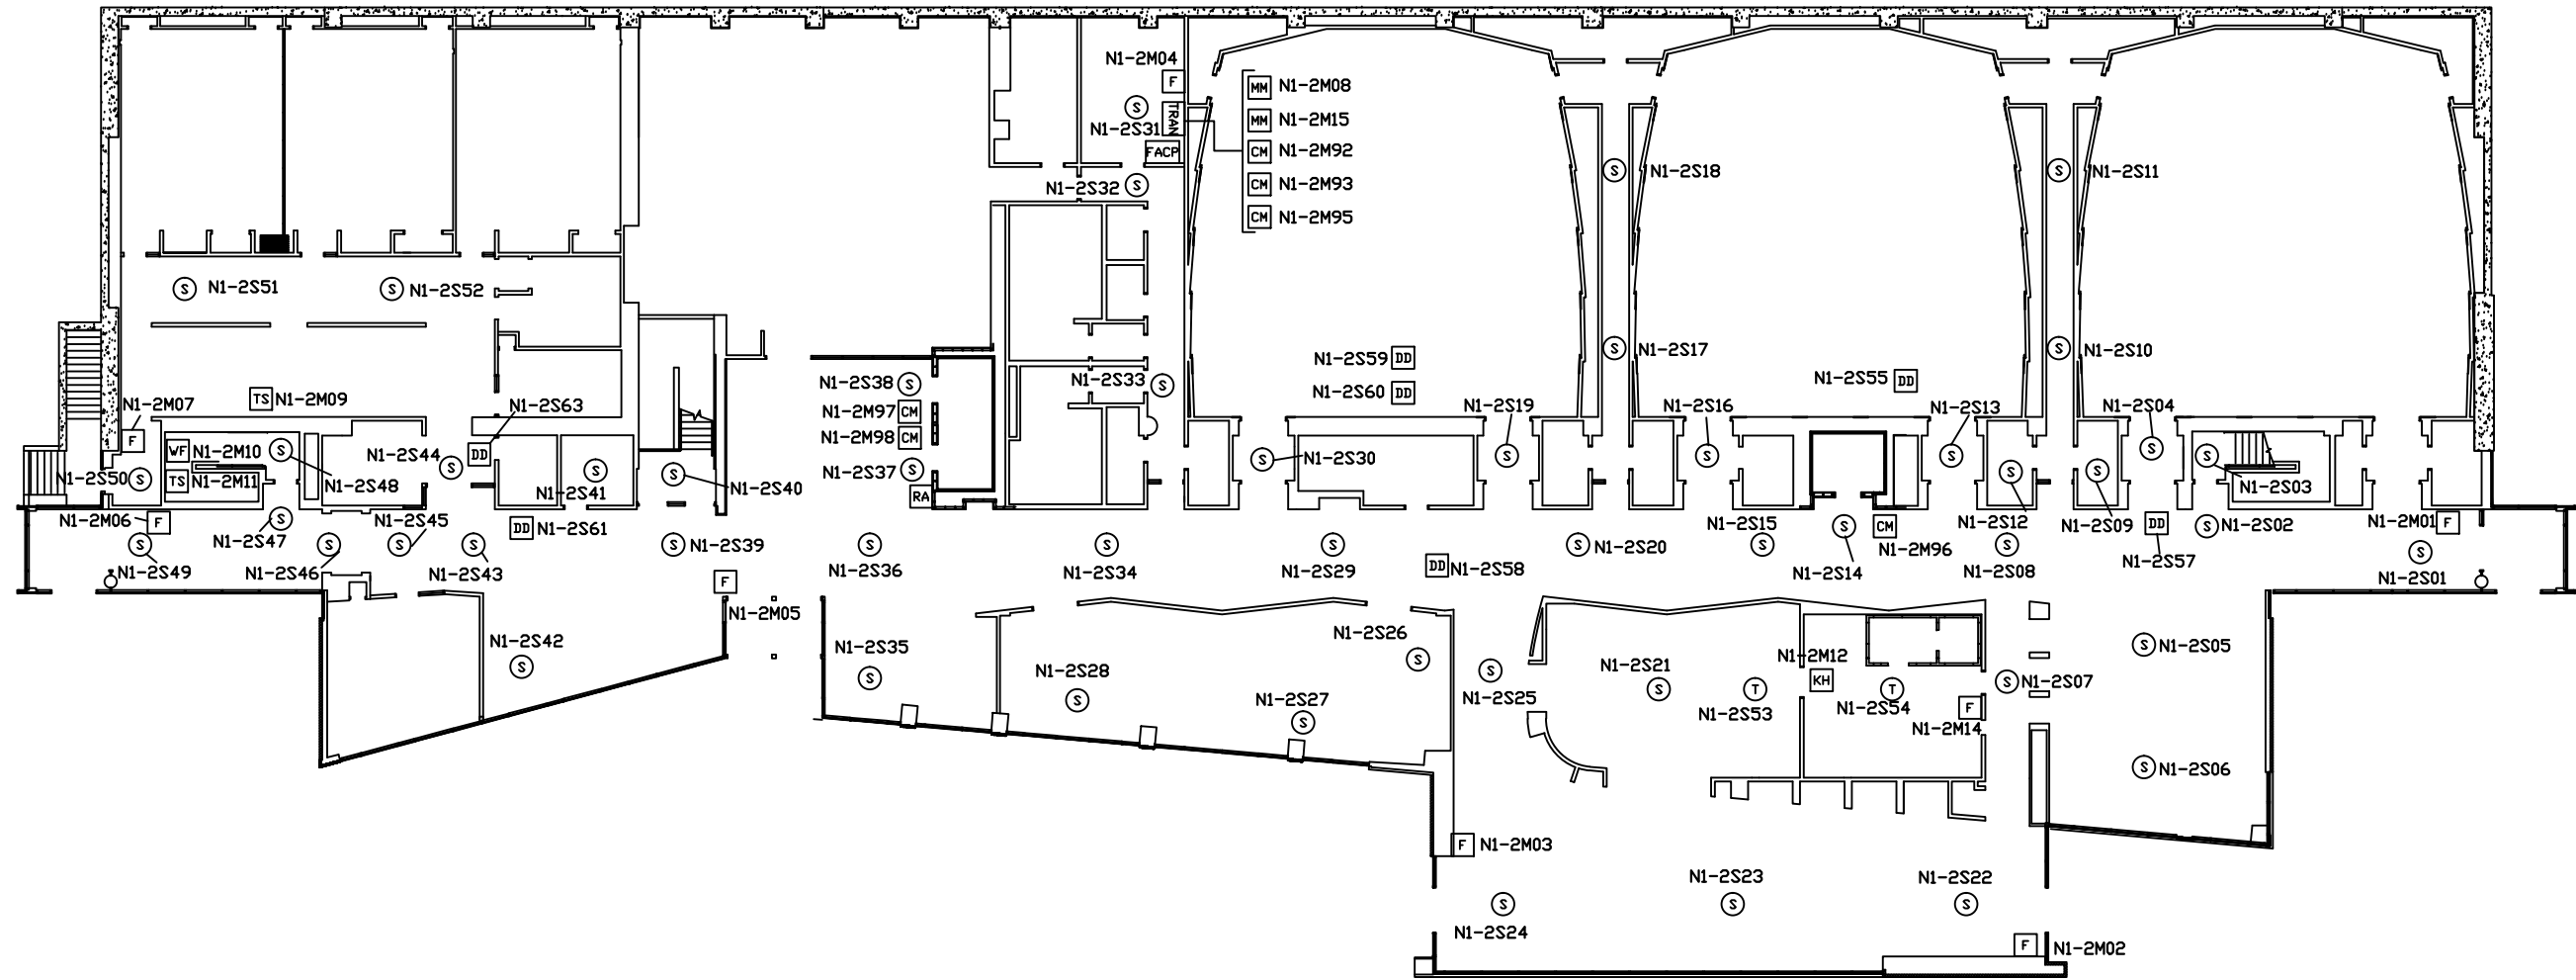

AS BUILTS PER ARCO ELECTRIC



DEVICE LEGEND	
SYMBOL	DESCRIPTION
Ⓢ	SMOKE DETECTOR W/BASE
Ⓣ	THERMAL DETECTOR
F	MANUAL PULL STATION
DD	DUCT SMOKE DETECTOR
WF	WATERFLOW SWITCH MONITOR MODULE
TS	TAMPER SWITCH MONITOR MODULE
MM	MONITOR MODULE
CM	CONTROL MODULE
KH	KITCHEN HOOD MONITOR MODULE
RA	REMOTE ANNUNCIATOR ENCLOSURE
FACP	FIRE ALARM CONTROL PANEL
TRAN	TRANSPONDER PANEL

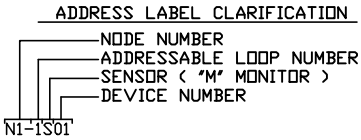

HEALTH SCIENCES EDUCATION BUILDING
UNIVERSITY OF UTAH
FIRST FLOOR

NFS NELSON FIRE SYSTEMS 801-468-8300	
DRAWN BY:	DPS
DESIGNED BY:	XXXX
APPROVED BY:	TCT
DATE:	12/7/2005
SCALE:	N.T.S.
PROJECT NO:	XXXX
REV NO:	XXXX
DRAWING NAME:	HEALTHSCII.DWG

FIRE ALARM SYSTEM
FIRST FLOOR
NFS

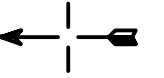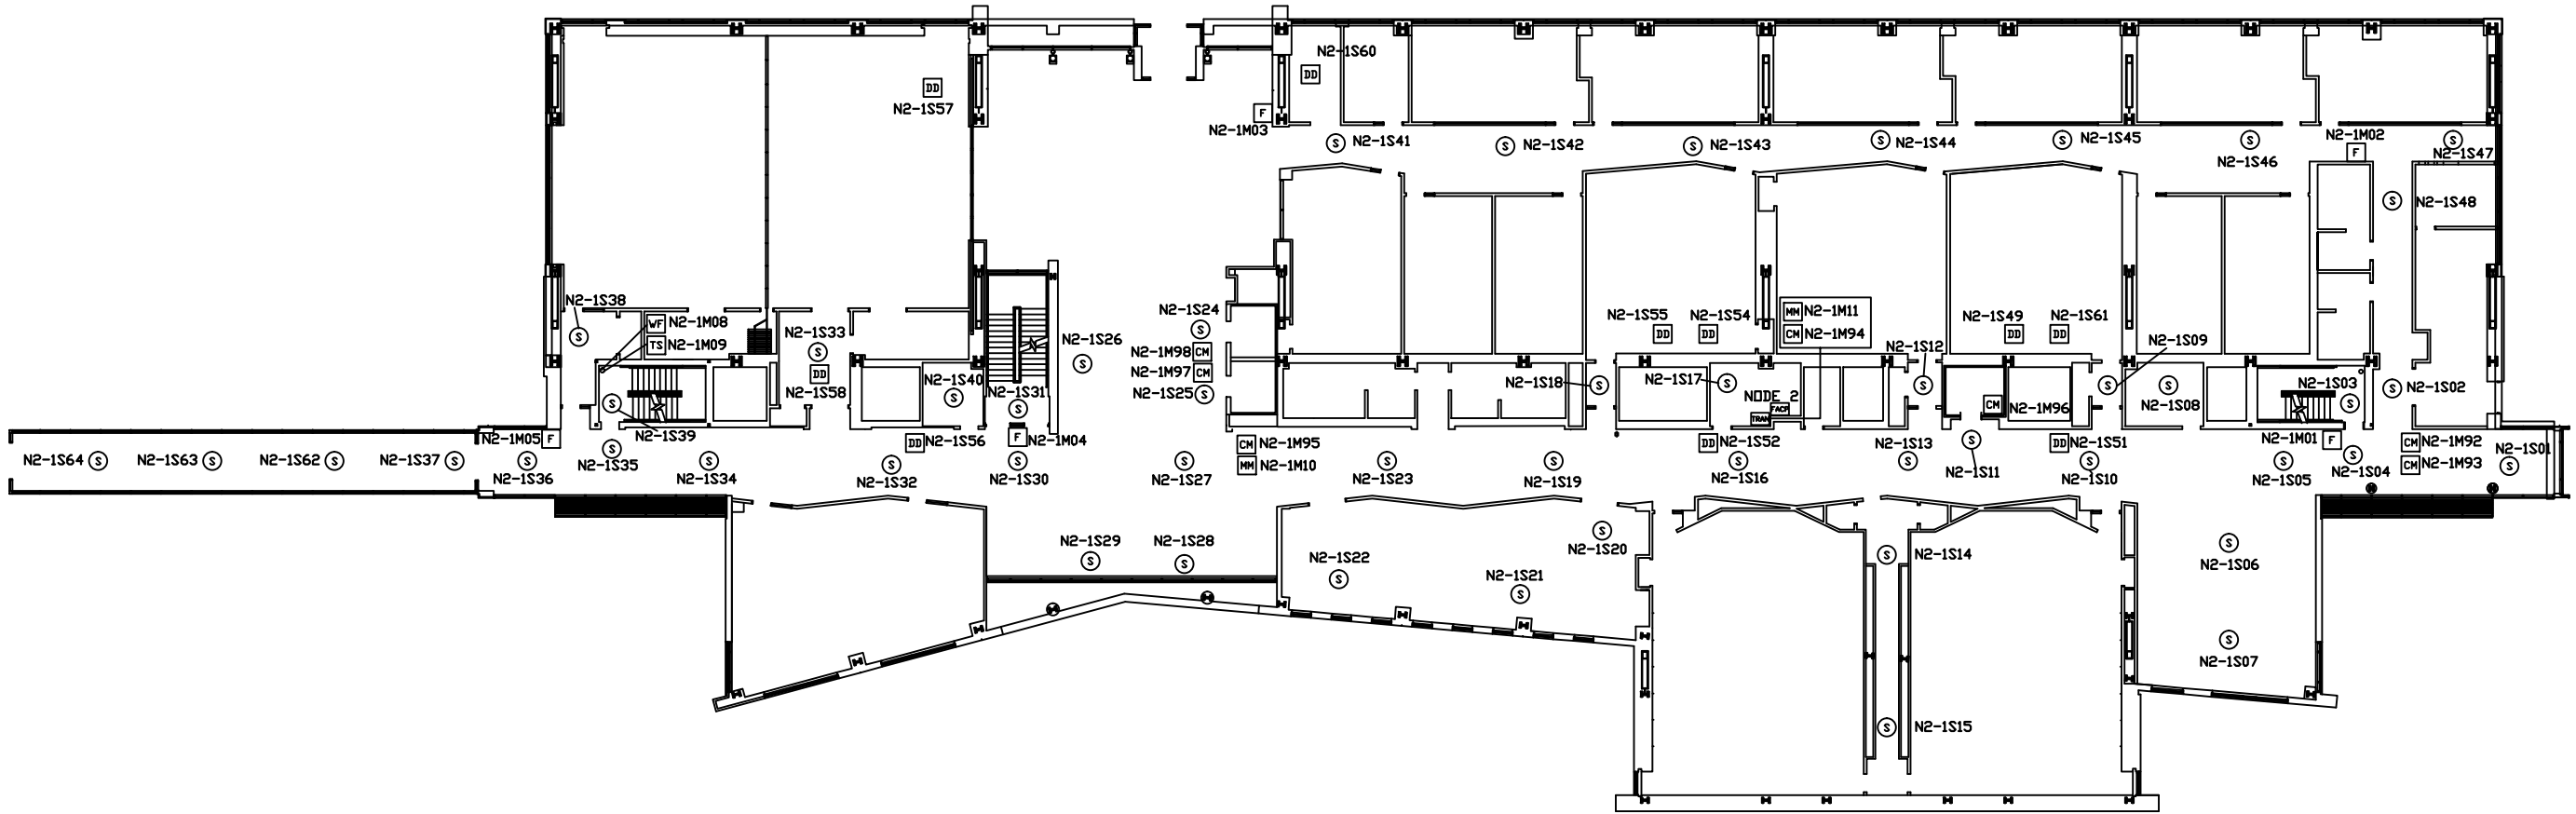


NOTE:
NFS DRAWINGS ARE BASED ON THE PROJECT
ARCHITECT/ENGINEER (A/E) PLANS AND SPECIFICATIONS
FURNISHED TO NFS. A/E IS SOLELY RESPONSIBLE
(NOT NFS) FOR THE TYPE, SIZE, LOCATION, AND
SUITABILITY OF ALL FIRE ALARMS, CONTROL PANELS,
AND OTHER DEVICES SHOWN ON THE A/E PLANS.
NFS DRAWINGS ARE TO SHOW ONLY THE WIRING
DIAGRAMS BETWEEN FIRE ALARM DEVICES AND
CONTROL PANELS. NFS IS NOT RESPONSIBLE FOR
THE INFORMATION SHOWN ON THE A/E PLANS.

HEALTH SCIENCES EDUCATION BUILDING
UNIVERSITY OF UTAH
SECOND LEVEL

DRAWN BY:	DPS
DESIGNED BY:	XXXX
APPROVED BY:	TCT
DATE:	12/7/2005
SCALE:	N.T.S.
PROJECT NO:	XXXX
REV NO:	XXXX
DRAWING NAME:	HEALTHSCI2.DWG

FIRE ALARM SYSTEM
SECOND FLOOR

NFS

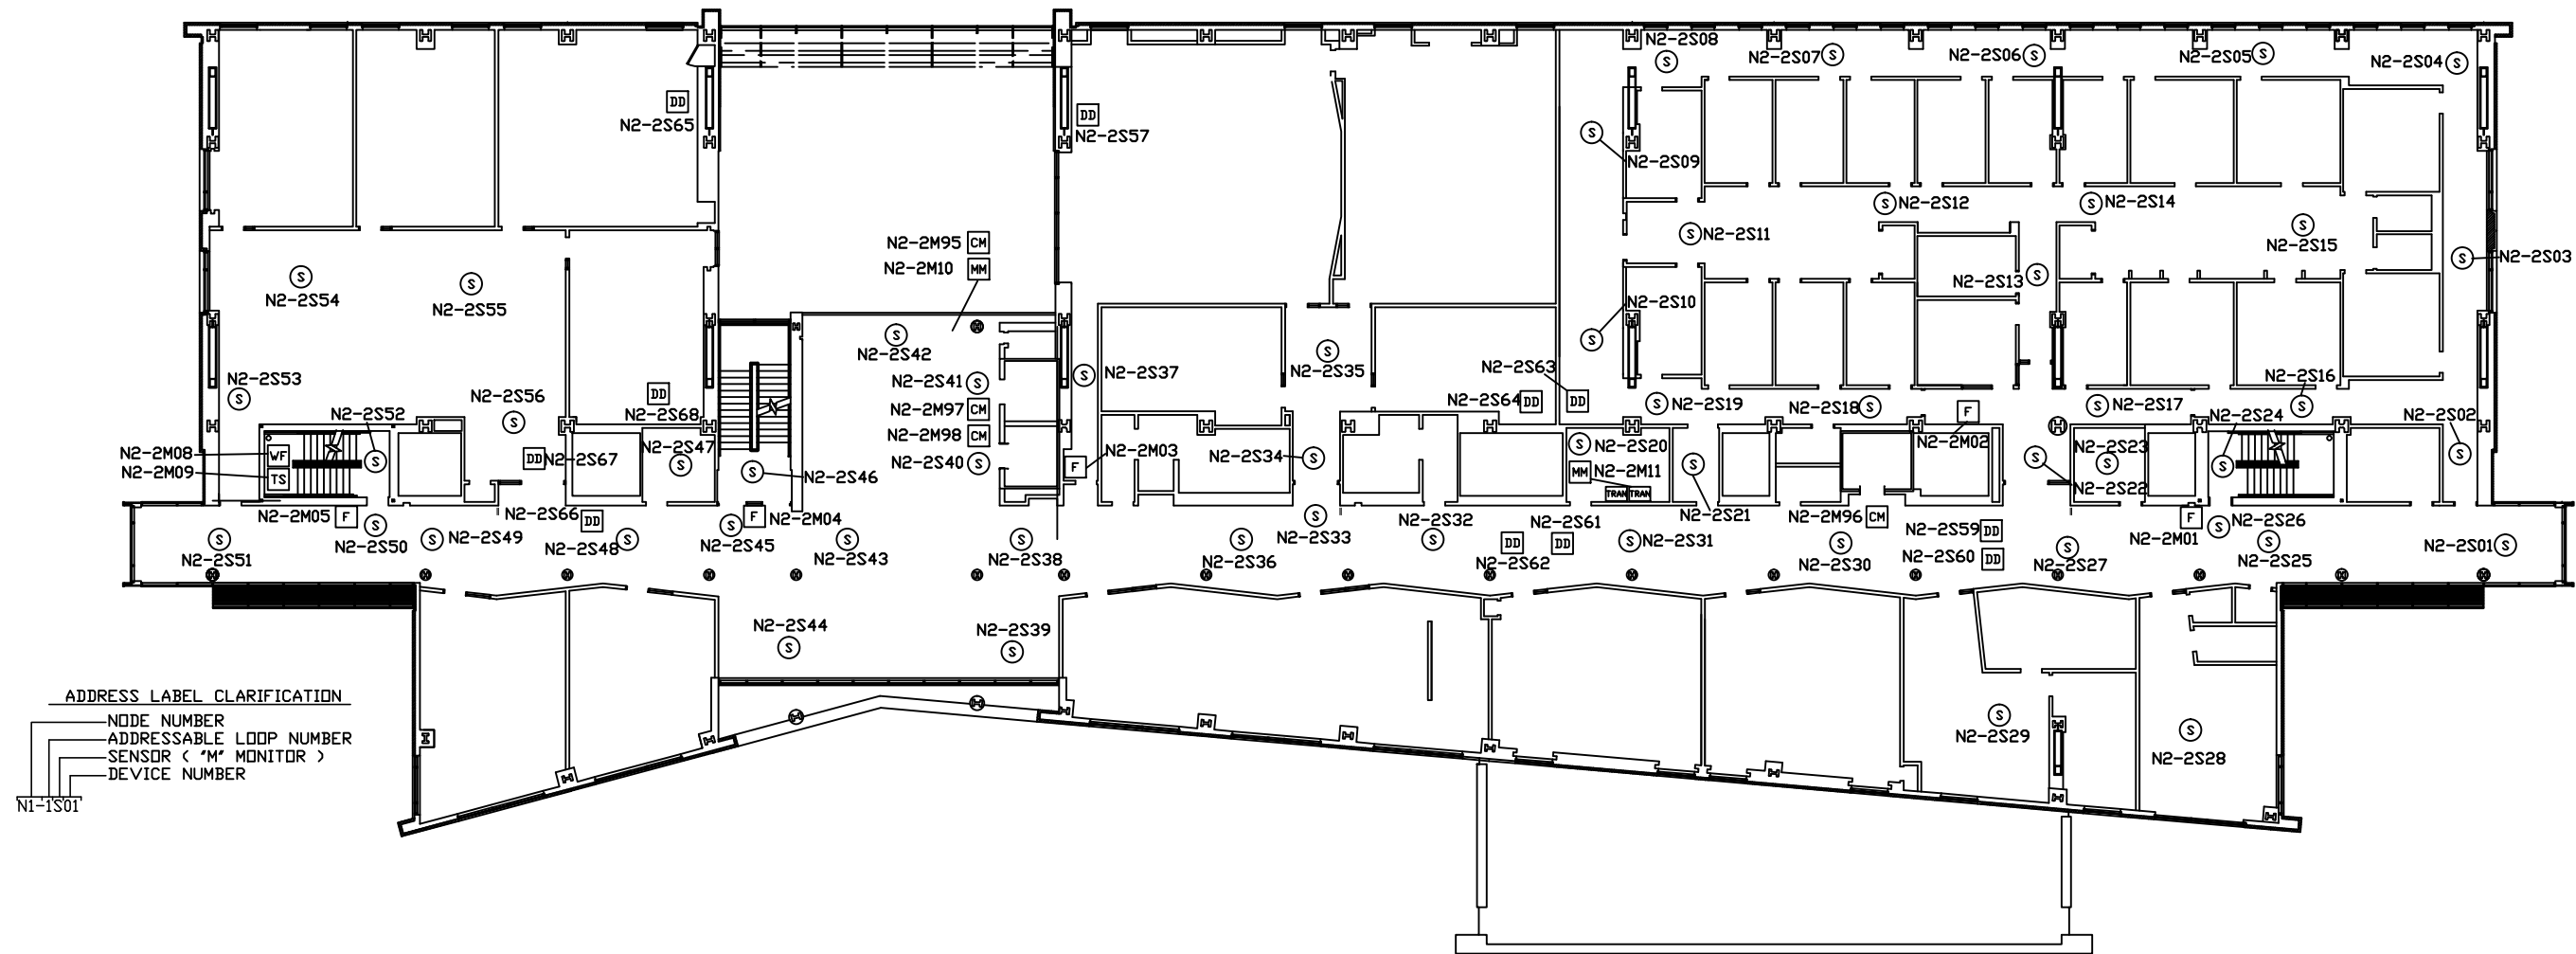


ADDRESS LABEL CLARIFICATION

- NODE NUMBER
- ADDRESSABLE LOOP NUMBER
- SENSOR ("M" MONITOR)
- DEVICE NUMBER

DEVICE LEGEND	
SYMBOL	DESCRIPTION
Ⓢ	SMOKE DETECTOR W/BASE
Ⓣ	THERMAL DETECTOR
F	MANUAL PULL STATION
DD	DUCT SMOKE DETECTOR
WF	WATERFLOW SWITCH MONITOR MODULE
TS	TAMPER SWITCH MONITOR MODULE
L	STROBE LIGHT
SS	SPEAKER/STROBE
S	SPEAKER ONLY
MM	MONITOR MODULE
CM	CONTROL MODULE
R	RELAY- ARB-C
DH	DOORHOLDER
RA	REMOTE ANNUNCIATOR ENCLOSURE
FACP	FIRE ALARM CONTROL PANEL
TRAN	TRANSPONDER PANEL

AS BUILTS PER ARCO ELECTRIC

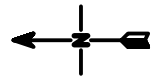

NOTE:
NFS DRAWINGS ARE BASED ON THE PROJECT
ARCHITECT/ENGINEER (A/E) PLANS AND SPECIFICATIONS
FURNISHED TO NFS. A/E IS SOLELY RESPONSIBLE
(NOT NFS) FOR THE TYPE, SIZE, LOCATION, AND
SUITABILITY OF ALL FIRE ALARMS, CONTROL PANELS,
AND OTHER DEVICES SHOWN ON THE A/E PLANS.
NFS DRAWINGS ARE TO SHOW ONLY THE WIRING
DIAGRAMS BETWEEN FIRE ALARM DEVICES AND
CONTROL PANELS. NFS IS NOT RESPONSIBLE FOR
THE INFORMATION SHOWN ON THE A/E PLANS.


HEALTH SCIENCES EDUCATION BUILDING
UNIVERSITY OF UTAH
THIRD FLOOR

NFS
NELSON FIRE SYSTEMS
801-468-8300

DRAWN BY: DPS
DESIGNED BY: XXXX
APPROVED BY: TCT
DATE: 12/7/2005
SCALE: N.T.S.
PROJECT NO: XXXX
REV NO: XXXX
DRAWING NAME:
HEALTHSCI3.DWG


FIRE ALARM SYSTEM
THIRD FLOOR

NFS

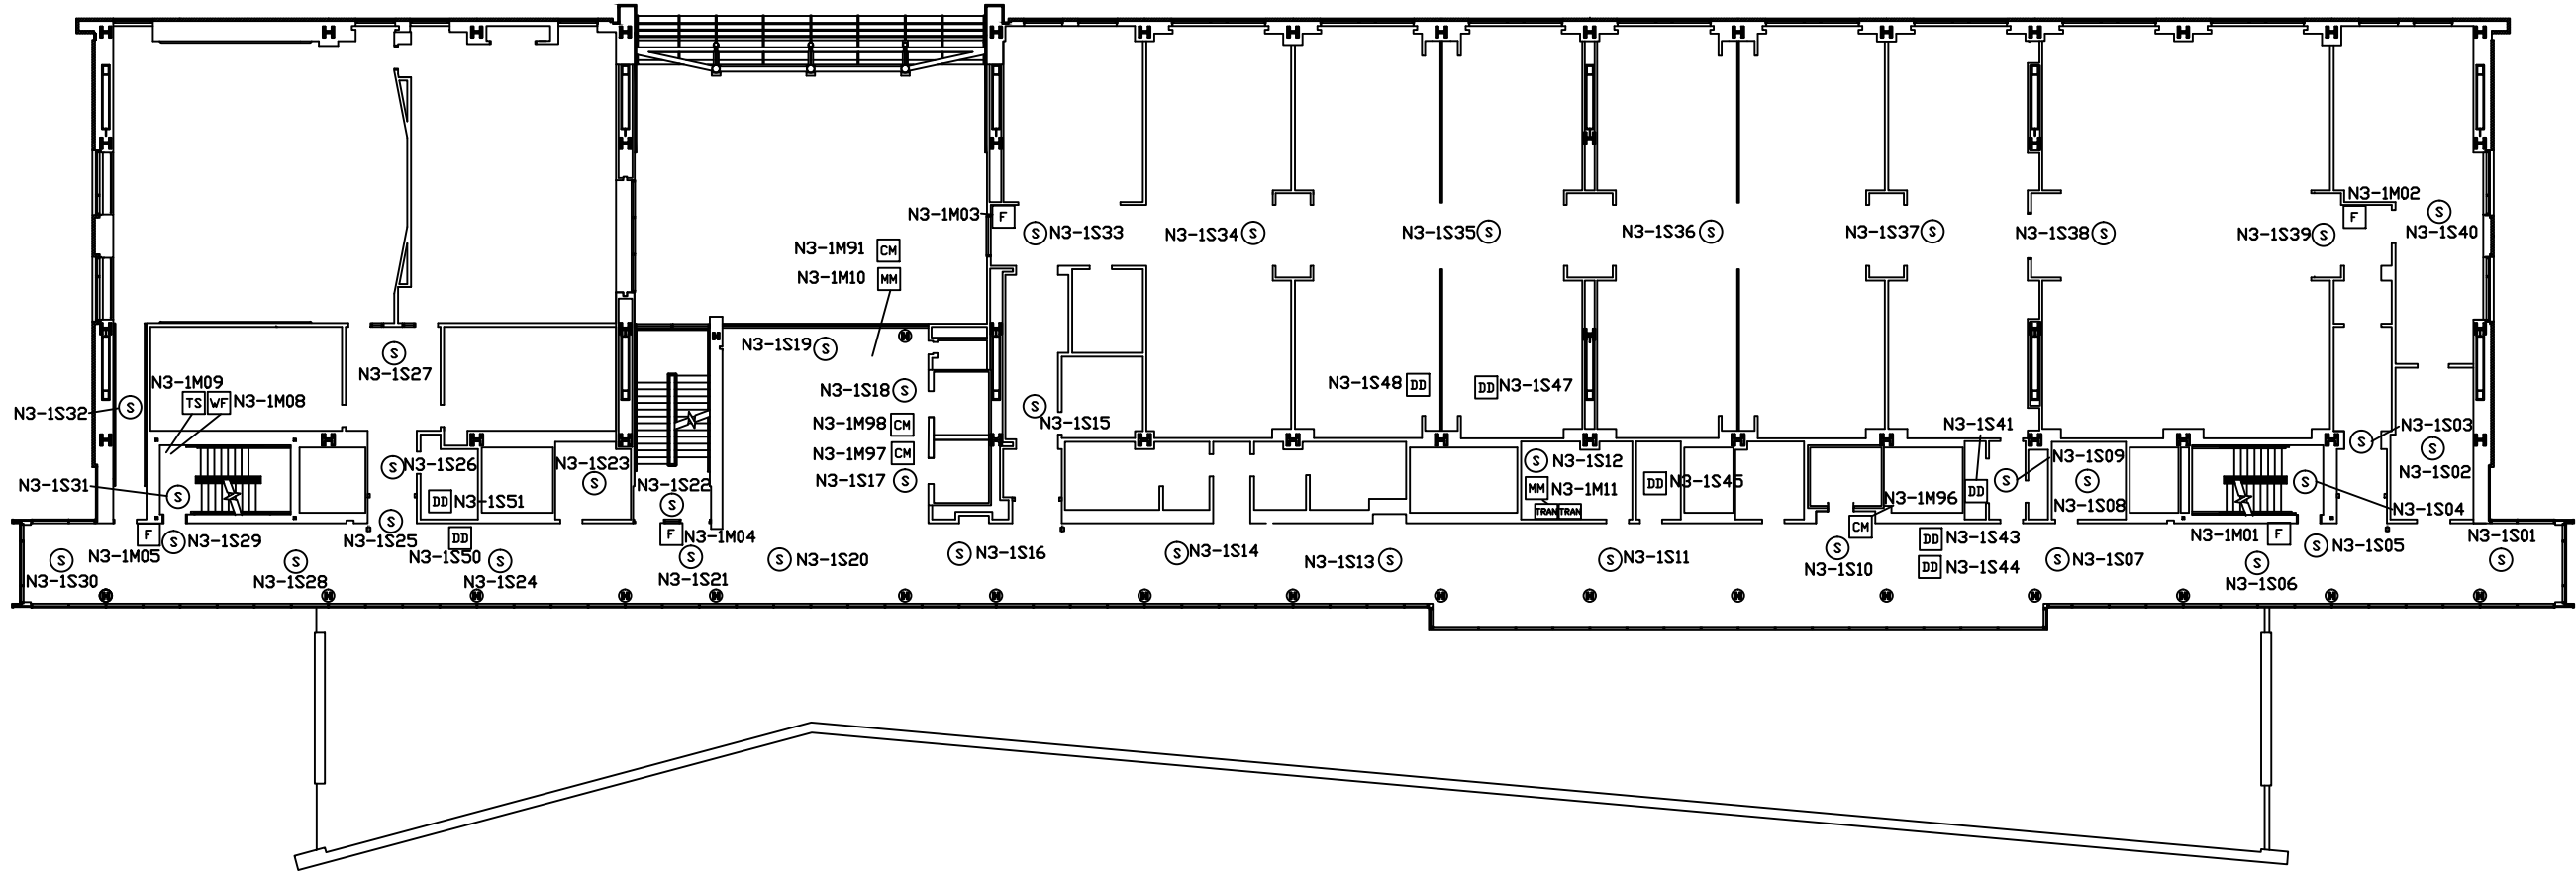

AS BUILTS PER ARCO ELECTRIC

DEVICE LEGEND	
SYMBOL	DESCRIPTION
Ⓢ	SMOKE DETECTOR W/BASE
Ⓣ	THERMAL DETECTOR
F	MANUAL PULL STATION
DD	DUCT SMOKE DETECTOR
WF	WATERFLOW SWITCH MONITOR MODULE
TS	TAMPER SWITCH MONITOR MODULE
L	STROBE LIGHT
SS	SPEAKER/STROBE
S	SPEAKER ONLY
MM	MONITOR MODULE
CM	CONTROL MODULE
KH	KITCHEN HOOD MONITOR MODULE
R	RELAY- ARB-C
DH	DOORHOLDER
RA	REMOTE ANNUNCIATOR ENCLOSURE
FACP	FIRE ALARM CONTROL PANEL
TRAN	TRANSPONDER PANEL

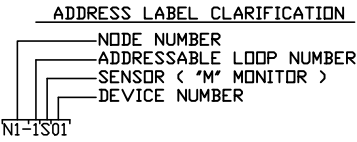

NOTE:
NFS DRAWINGS ARE BASED ON THE PROJECT ARCHITECT/ENGINEER (A/E) PLANS AND SPECIFICATIONS FURNISHED TO NFS. A/E IS SOLELY RESPONSIBLE (NOT NFS) FOR THE TYPE, SIZE, LOCATION, AND SUITABILITY OF ALL FIRE ALARMS, CONTROL PANELS, AND OTHER DEVICES SHOWN ON THE A/E PLANS. NFS DRAWINGS ARE TO SHOW ONLY THE WIRING DIAGRAMS BETWEEN FIRE ALARM DEVICES AND CONTROL PANELS. NFS IS NOT RESPONSIBLE FOR THE INFORMATION SHOWN ON THE A/E PLANS.


HEALTH SCIENCES EDUCATION BUILDING
UNIVERSITY OF UTAH
FOURTH FLOOR

NFS
NELSON FIRE SYSTEMS
801-468-8300

DRAWN BY:	DPS
DESIGNED BY:	XXXX
APPROVED BY:	TCT
DATE:	12/7/2005
SCALE:	N.T.S.
PROJECT NO:	XXXX
REV NO:	XXXX
DRAWING NAME:	HEALTHSCI4.DWG


FIRE ALARM SYSTEM
FOURTH FLOOR

NFS

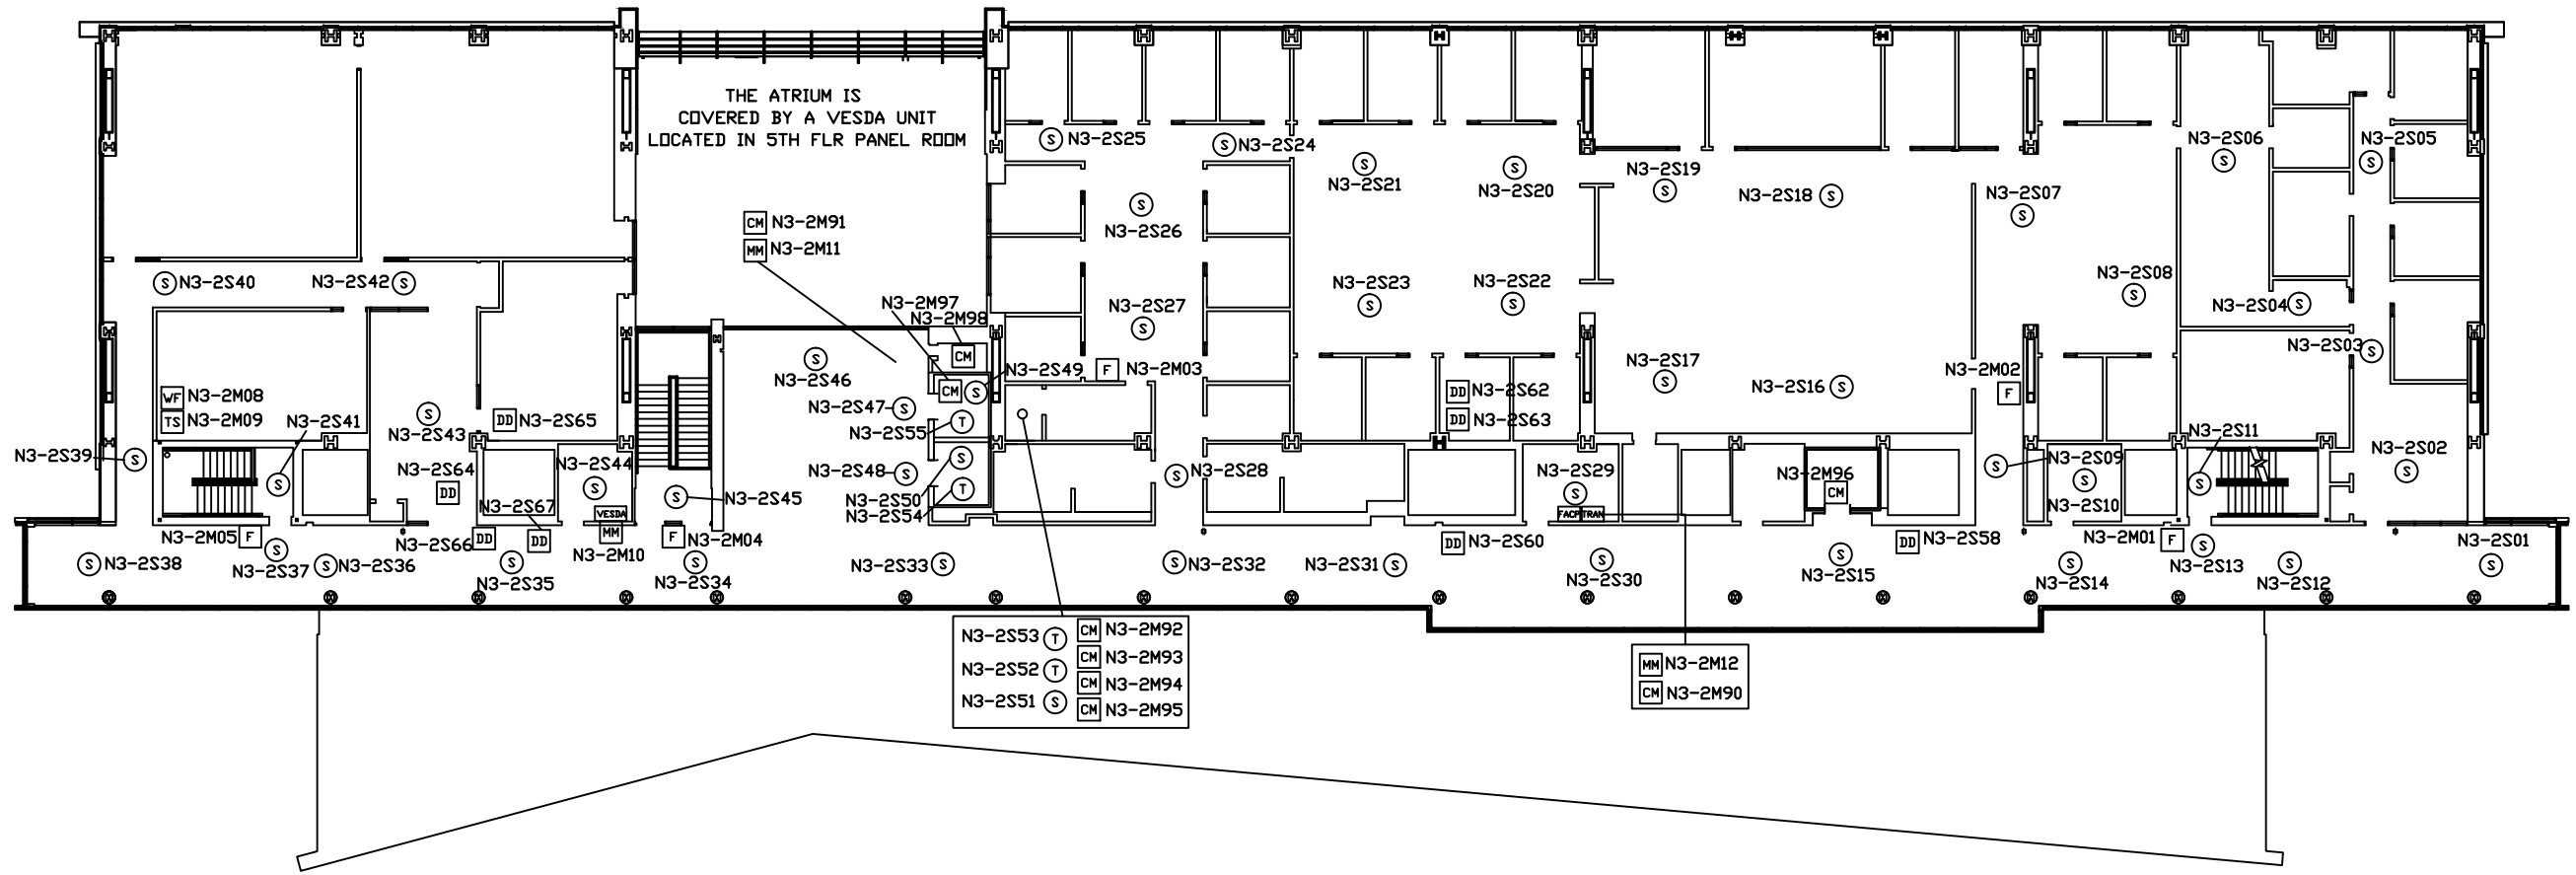

AS BUILTS PER ARCO ELECTRIC

DEVICE LEGEND	
SYMBOL	DESCRIPTION
Ⓢ	SMOKE DETECTOR W/BASE
Ⓣ	THERMAL DETECTOR
F	MANUAL PULL STATION
DD	DUCT SMOKE DETECTOR
WF	WATERFLOW SWITCH MONITOR MODULE
TS	TAMPER SWITCH MONITOR MODULE
L	STROBE LIGHT
SS	SPEAKER/STROBE
S	WEATHERPROOF SPEAKER
MM	MONITOR MODULE
CM	CONTROL MODULE
R	RELAY- ARB-C
DH	DOORHOLDER
FACP	FIRE ALARM CONTROL PANEL
TRAN	TRANSPONDER PANEL
B _T	BEAM DETECTOR-TRANSMITTER
B _R	BEAM DETECTOR-RECEIVER
BC	BEAM DETECTOR CONTROLLER

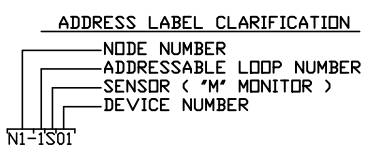

NOTE:
NFS DRAWINGS ARE BASED ON THE PROJECT ARCHITECT/ENGINEER (A/E) PLANS AND SPECIFICATIONS FURNISHED TO NFS. A/E IS SOLELY RESPONSIBLE (NOT NFS) FOR THE TYPE, SIZE, LOCATION, AND SUITABILITY OF ALL FIRE ALARMS, CONTROL PANELS, AND OTHER DEVICES SHOWN ON THE A/E PLANS. NFS DRAWINGS ARE TO SHOW ONLY THE WIRING DIAGRAMS BETWEEN FIRE ALARM DEVICES AND CONTROL PANELS. NFS IS NOT RESPONSIBLE FOR THE INFORMATION SHOWN ON THE A/E PLANS.


HEALTH SCIENCES EDUCATION BUILDING
UNIVERSITY OF UTAH
FIFTH LEVEL

NFS
NELSON FIRE SYSTEMS
801-468-8300

DRAWN BY:	DPS
DESIGNED BY:	XXXX
APPROVED BY:	TCT
DATE:	12/7/2005
SCALE:	N.T.S.
PROJECT NO:	XXXX
REV NO:	XXXX
DRAWING NAME:	HEALTHSCI5.DWG


FIRE ALARM SYSTEM
FIFTH FLOOR

NFS

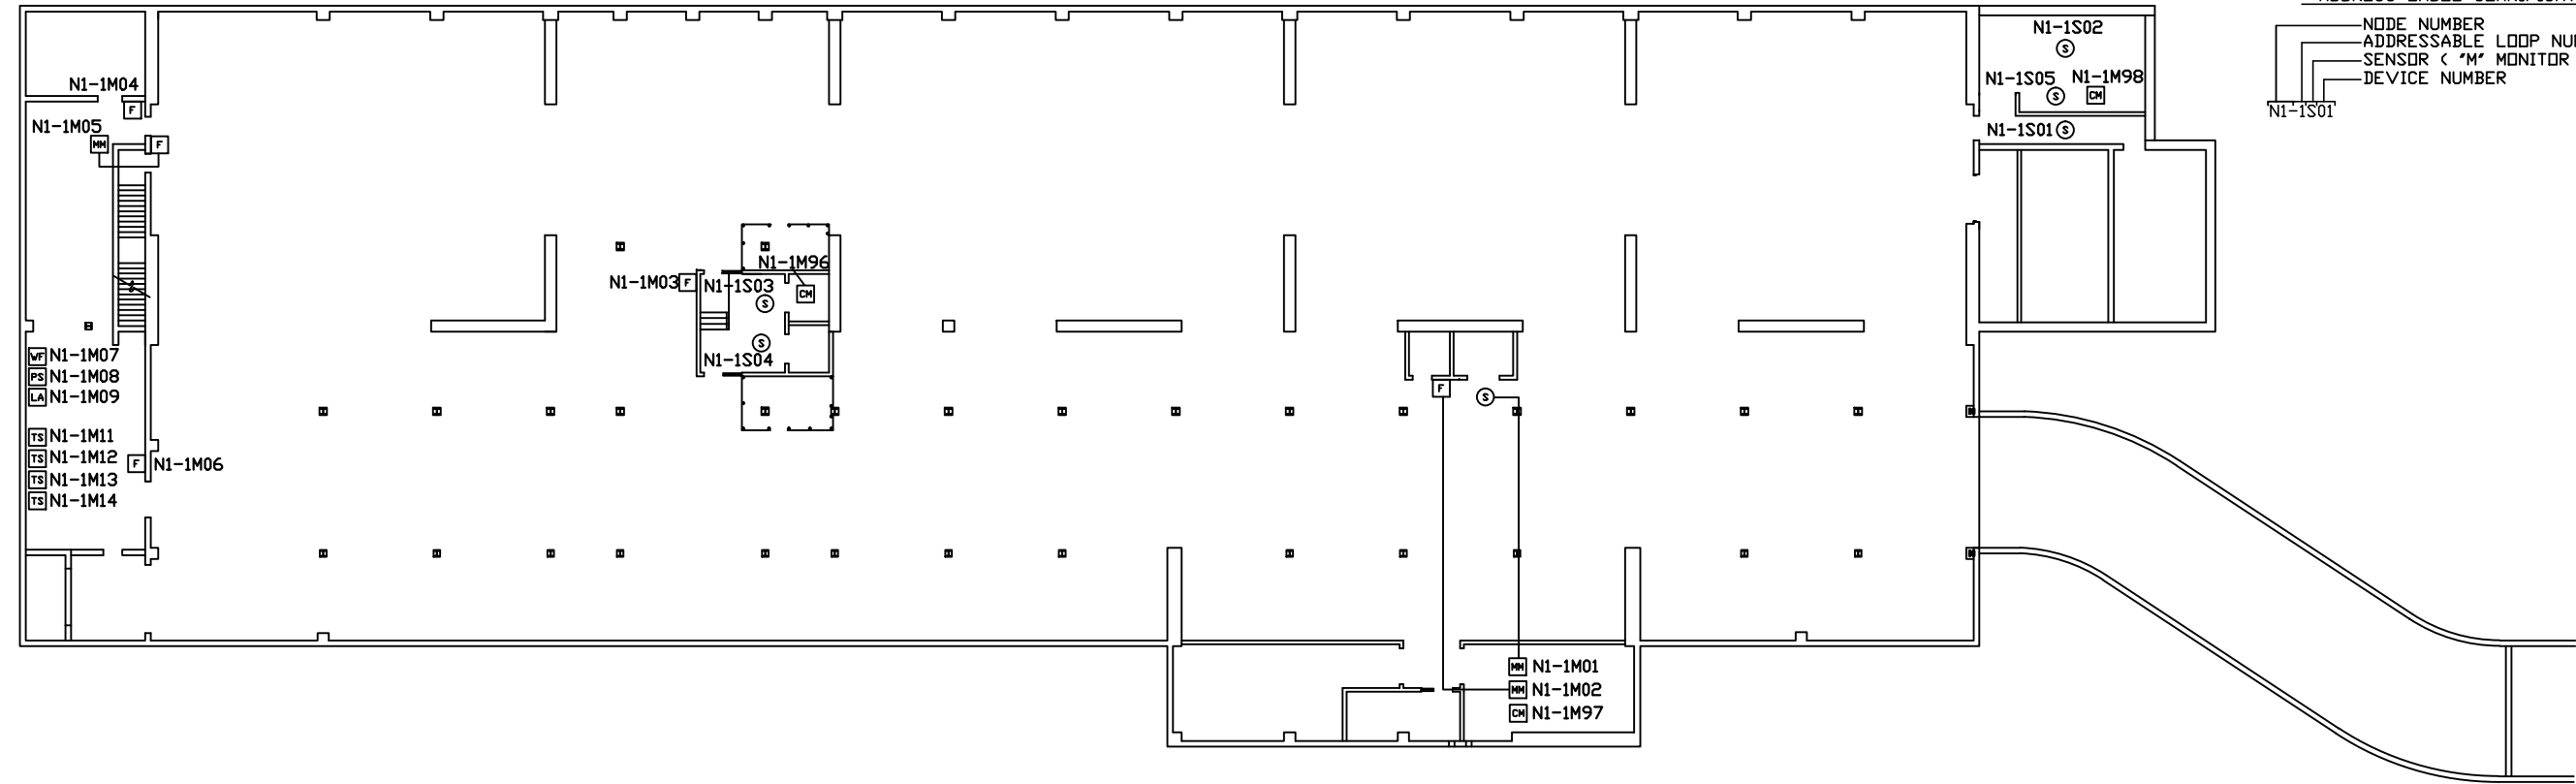

DEVICE LEGEND	
SYMBOL	DESCRIPTION
Ⓢ	SMOKE DETECTOR W/BASE
ⓕ	MANUAL PULL STATION
Ⓦⓕ	WATERFLOW SWITCH MONITOR MODULE
ⓉⓈ	TAMPER SWITCH MONITOR MODULE
Ⓛⓐ	LOW AIR SWITCH
ⓅⓈ	PRESSURE SWITCH
ⓂⓂ	MONITOR MODULE
ⓐⓂ	CONTROL MODULE
Ⓡ	RELAY- ARB-C

AS BUILTS PER ARCO ELECTRIC

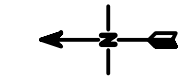

NOTE:
NFS DRAWINGS ARE BASED ON THE PROJECT ARCHITECT/ENGINEER (A/E) PLANS AND SPECIFICATIONS FURNISHED TO NFS. A/E IS SOLELY RESPONSIBLE (NOT NFS) FOR THE TYPE, SIZE, LOCATION, AND SUITABILITY OF ALL FIRE ALARMS, CONTROL PANELS, AND OTHER DEVICES SHOWN ON THE A/E PLANS. NFS DRAWINGS ARE TO SHOW ONLY THE WIRING DIAGRAMS BETWEEN FIRE ALARM DEVICES AND CONTROL PANELS. NFS IS NOT RESPONSIBLE FOR THE INFORMATION SHOWN ON THE A/E PLANS.


HEALTH SCIENCES EDUCATION BUILDING
UNIVERSITY OF UTAH
BASEMENT LEVEL

NFS
NELSON FIRE SYSTEMS
801-468-8300

DRAWN BY:	DPS
DESIGNED BY:	XXXX
APPROVED BY:	TCT
DATE:	12/7/2005
SCALE:	N.T.S.
PROJECT NO:	XXXX
REV NO:	XXXX
DRAWING NAME:	HEALTHSCIB.DWG

FIRE ALARM SYSTEM
BASEMENT

NFS

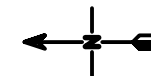

NOTE:
NFS DRAWINGS ARE BASED ON THE PROJECT
ARCHITECT/ENGINEER (A/E) PLANS AND SPECIFICATIONS
FURNISHED TO NFS. A/E IS SOLELY RESPONSIBLE
(NOT NFS) FOR THE TYPE, SIZE, LOCATION, AND
SUITABILITY OF ALL FIRE ALARMS, CONTROL PANELS,
AND OTHER DEVICES SHOWN ON THE A/E PLANS.
NFS DRAWINGS ARE TO SHOW ONLY THE WIRING
DIAGRAMS BETWEEN FIRE ALARM DEVICES AND
CONTROL PANELS. NFS IS NOT RESPONSIBLE FOR
THE INFORMATION SHOWN ON THE A/E PLANS.


HEALTH SCIENCES EDUCATION BUILDING
UNIVERSITY OF UTAH
PENTHOUSE

NFS
NELSON FIRE SYSTEMS
801-468-8300

DRAWN BY:	DPS
DESIGNED BY:	XXXX
APPROVED BY:	TCT
DATE:	6/23/2005
SCALE:	N.T.S.
PROJECT NO:	XXXX
REV NO:	XXXX
DRAWING NAME:	HEALTHSCIP.DWG

FIRE ALARM SYSTEM
PENTHOUSE
ADDRESSABLE LOOP NUMBERS

NFS
FA-P-04

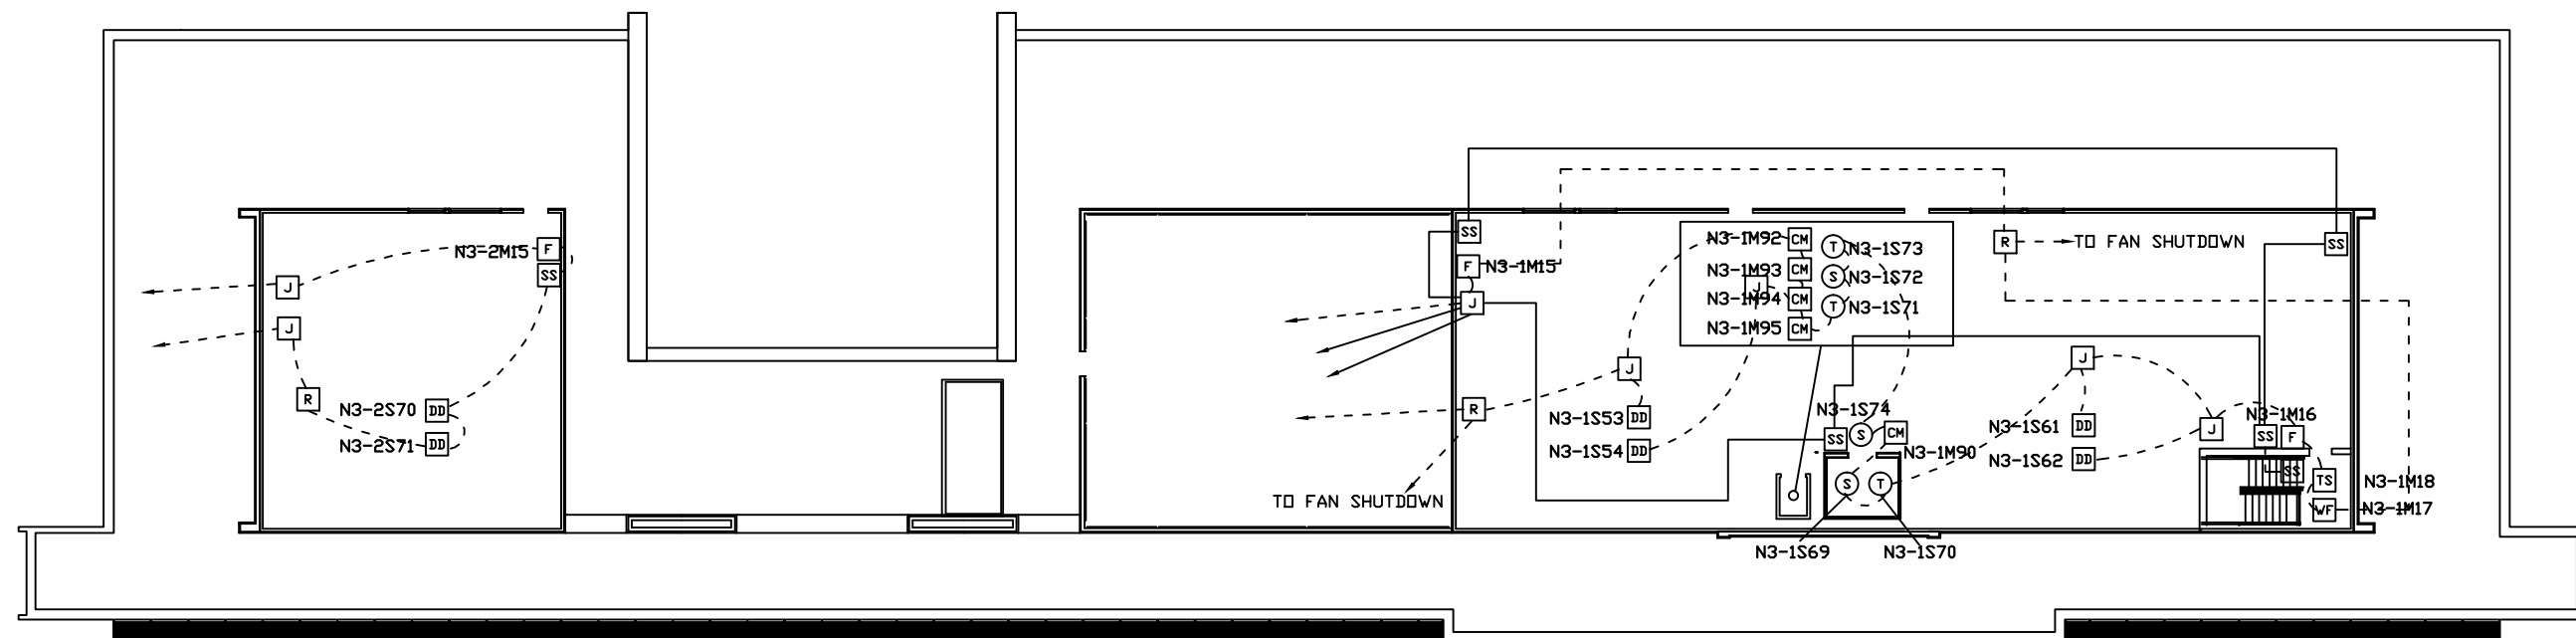

DEVICE LEGEND

SYMBOL	DESCRIPTION
Ⓢ	SMOKE DETECTOR W/BASE
Ⓣ	THERMAL DETECTOR
ⓕ	MANUAL PULL STATION
ⒹⒹ	DUCT SMOKE DETECTOR
Ⓦⓕ	WATERFLOW SWITCH MONITOR MODULE
ⓉⓈ	TAMPER SWITCH MONITOR MODULE
Ⓛ	STROBE LIGHT
ⓈⓈ	SPEAKER/STROBE
Ⓢ	WEATHERPROOF SPEAKER
ⓂⓂ	MONITOR MODULE
ⒸⓂ	CONTROL MODULE
ⓀⓂ	KITCHEN HOOD MONITOR MODULE
Ⓡ	RELAY- ARB-C
ⒹⓂ	DOORHOLDER
Ⓡⓐ	REMOTE ANNUNCIATOR ENCLOSURE
ⓕⓐⒸⓕ	FIRE ALARM CONTROL PANEL
ⓉⓇⓐⓃ	TRANSPONDER PANEL

ADDRESS LABEL CLARIFICATION

