

NOTE:
NFS DRAWINGS ARE BASED ON THE PROJECT
ARCHITECT/ENGINEER (A/E) PLANS AND SPECIFICATIONS
FURNISHED TO NFS. A/E IS SOLELY RESPONSIBLE
(NOT NFS) FOR THE TYPE, SIZE, LOCATION, AND
SUITABILITY OF ALL FIRE ALARMS, CONTROL PANELS,
AND OTHER DEVICES SHOWN ON THE A/E PLANS.
NFS DRAWINGS ARE TO SHOW ONLY THE WIRING
DIAGRAMS BETWEEN FIRE ALARM DEVICES AND
CONTROL PANELS. NFS IS NOT RESPONSIBLE FOR
THE INFORMATION SHOWN ON THE A/E PLANS.

NPS PHARMACEUTICALS LABORATORY/OFFICE
UNIVERSITY OF UTAH RESEARCH PARK
LEVEL 1 AND LEVEL 2
FIRE ALARM SYSTEM
SALT LAKE CITY, UTAH


NFS
NELSON FIRE SYSTEMS
801-468-8300

DRAWN BY:	DB
DESIGNED BY:	XXXX
APPROVED BY:	XXXX
DATE:	10/4/13
SCALE:	N.T.S.
PROJECT NO:	XXXX
REV NO:	XXXX
DRAWING NAME:	NPS PHARMIAN2.DWG


FIRE ALARM SYSTEM
AS-BUILTS

PAGE:

LEVEL 2

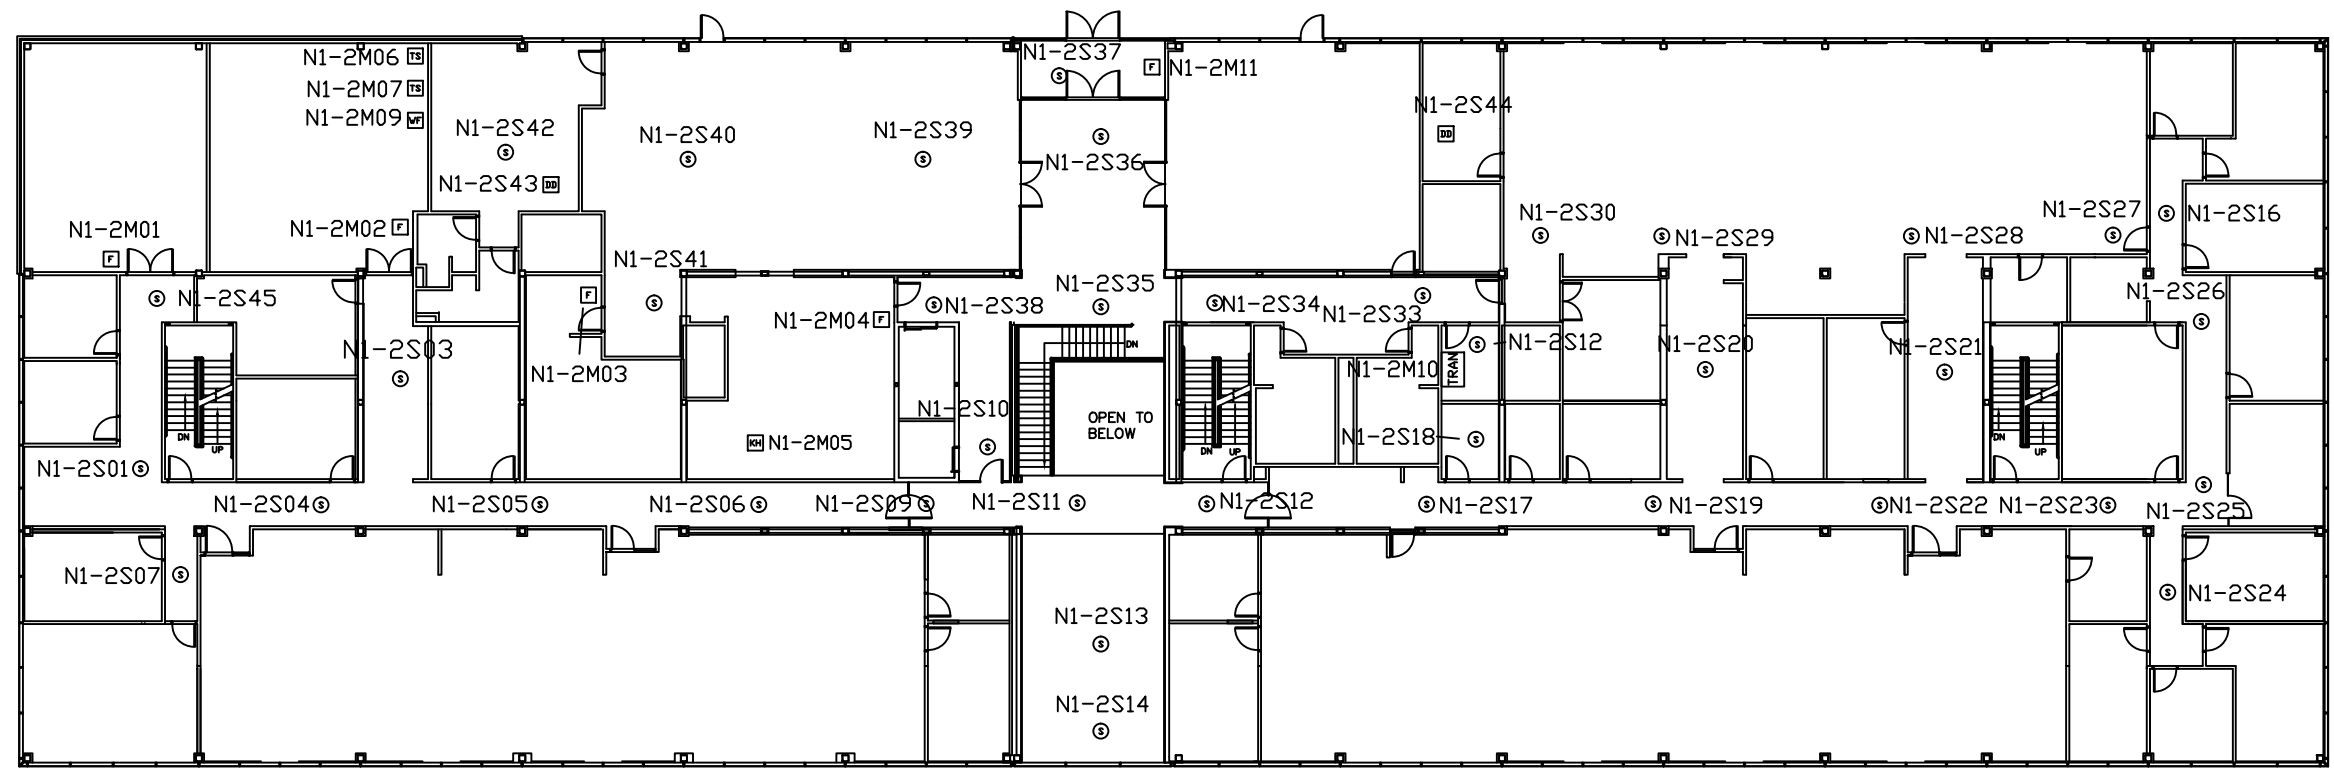

ADDRESS LABEL CLARIFICATION

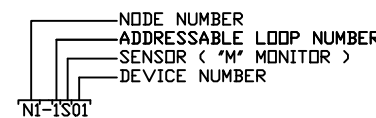

LEVEL 1

